

LABOR AND MATERIALS

1 Copper Lead	Connection	3/4		\$ 1.31
1 Curb	Cock Valve T. S. & V.	3/4	in.	\$ 1.75
1 Service Box Old returned			Short 3 1/2 x 4 1/2	
			Long 4 1/2 x 5 1/2	
			Buff. or Rdway	\$ 1.60
26 Ft. 3/4	Copper Galv. Iron Cast Iron	Pipe at	18	\$ 4.68
Nipples	in.	at		\$
Bushings	to	in.	at	\$
Red'g Inc'g	Couplings	to	in.	at
Union	in.	at		\$
Meter	in.	at		\$
Lead Joints	at			\$
Leadite Joints	at			\$
Hrs. Foreman	at			\$
2 Hrs. Chauffeur	at	6 3/4		\$ 1.25
8 Hrs. Tapper	at			\$ 5.-
13 Hrs. Labor	at	45		\$ 5.85
Hrs. Labor	at			\$
Hrs. Compressor	at			\$
Compensation Ins.				\$.37
Trucking				\$ 1.-
Builders Use of Water	Patch			\$ 5.-
<i>Tap by Panon.</i>				
<hr/>				
				\$ 27.81

241 - 1940

St.

Pl.


Davis Ave. No. 34

Name of Owner

Leatham

Labor and Mat'l. Report

Oct 24 1940

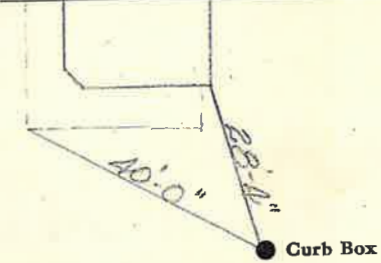

4 Main Elev. of Main at tap. 5-

Gate at ● ● Gate at

TAX ID # 302.15-13-1

● Curb Box