

LABOR AND MATERIALS


1	Copper Lead	} Connection $\frac{3}{4}$ "	\$
1	Curb		} Cock Valve F.S. & V. } $\frac{3}{4}$ " in.
1	Service box Old returned	} Short $3\frac{1}{2} \times 4\frac{1}{2}$ Long $4\frac{1}{2} \times 5\frac{1}{2}$	
25	Ft. $\frac{3}{4}$ in.		} Copper Curb C.P.
	Nipples	in. at \$	
	Bushings	to in. at \$	
	Red'g Inc'g	} Coupl'gs to in. at \$	
	Union		in. at \$
	Meter	in. at \$	
	Compound Joints	at \$	
	Maintenance Foreman	\$	
	Hrs. Water Maint. Man-1	at \$	
	Hrs. Water Maint. Man-2	at \$	
	Hrs. Garage Foreman	at \$	
	Hrs. Labor	at \$	
	Hrs. Compressor	at \$	
	Trucking	\$	
	Pav't Patch	\$	
		\$	
		\$	
DAVIS

St. ~~1~~ No. 36

Name of Owner

Labor and Mat'l. Report OCT. 31 1932

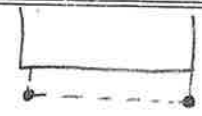

32'2" 28'

● Curb Box

4" Main

Elev. of Main at tap  $4\frac{1}{2}'$

Gate at ● Gate at

● Curb Box

OLD TAP SHUT OFF -  
MAIN ON LINCOLN AVE.