

LABOR AND MATERIALS

1	Copper	Connection	3/4	\$	1.23
1	Curb	Cock	3/4 in.	\$	1.68
1	Service Box	Short 3/2x4 1/2			
	Old returned	Long 4 1/2x5 1/2			
		Buff. or Redway			
7	Ft.	3/4 in.	Copper Galv. Iron Cast Iron	Pipe at 15	\$ 1.05
	Nipples	in. at		\$	
	Bushings	to in. at		\$	
	Red'g Inc'g	Couplings to in. at		\$	
	Union	in. at		\$	
	Meter	in. at		\$	
	Lead Joints	at		\$	
	Leadite Joints	at		\$	
	Hrs. Foreman	at		\$	
7	Hrs. Chauffeur	at 6 1/2		\$	1.25
3	Hrs. Tapper	at		\$	1.88
18	Hrs. Labor	at 45		\$	8.10
	Hrs. Labor	at		\$	
1	Hrs. Compressor	at 8 1/2		\$.87
	Compensation Ins.			\$.35
	Trucking			\$	1.00
	Builders Use of Water	no patch (B.T.)		\$	
		Tap by H. Brownell		\$	
				\$	
				\$	
				\$	
				\$	19.16

131 - 1938

St.

Davis

##

Ave. No. 30


Name of Owner

H. L. Brownell

Labor and Mat'l. Report

Sept 1

1938

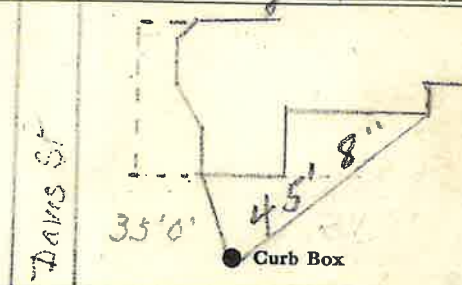

Lincoln Ave

14" Main

Elev. of Main at tap 4 1/2

Gate at ●

● Gate at

● Curb Box

TAP ON LINCOLN

old shut off