

### LABOR AND MATERIALS

Copper	}	Connection	\$
Lead			\$
Curb	{	Cock Valve T. S. & V.	in. \$
Service Box			\$
Old returned	}	Short 3 1/2 x 4 1/2	\$
		Long 4 1/2 x 5 1/2	
		Buff. or Rdway	
Ft. in.	}	Copper	Pipe at \$
		Galv Iron	
		Cast Iron	
Nipples	in. at	\$	
Bushings	to in. at	\$	
Red'g Inc'g	}	Couplings to in. at	\$
Union	in. at	\$	
Meter	in. at	\$	
Lead Joints	at	\$	
Leadite Joints	at	\$	
Hrs. Foreman	at	\$	
Hrs. Chauffeur	at	\$	
Hrs. Tapper	at	\$	
Hrs. Labor	at	\$	
Hrs. Labor	at	\$	
Hrs. Compressor	at	\$	
Compensation Ins.		\$	
Trucking		\$	
Builders Use of Water		\$	
		\$	
		\$	
		\$	
		\$	


St.  
Pl.  
Ave. No. 13

Davis

Name of Owner

Labor and Mat'l. Report

19 12

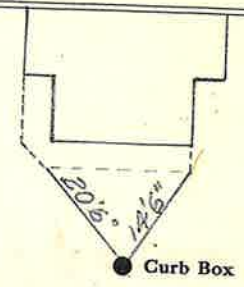

Main Elev. of Main at tap

---

Gate at ● ● Gate at

● Curb Box

PROBABLY RAZED