


LABOR AND MATERIALS

1	Copper	} Connection	$\frac{3}{4}$	_____	\$ _____
	Lead				
1	Curb	} Cock Valve	} $\frac{3}{4}$ in.	_____	\$ _____
1	Service box	} Short $3\frac{1}{2} \times 4\frac{1}{2}$	} Long $4\frac{1}{2} \times 5\frac{1}{2}$	_____	\$ _____
	Old returned				
25	Ft.	} Copper	} Pipe at	_____	\$ _____
	$\frac{3}{4}$ in.				
	Nipples	_____ in. at			\$ _____
	Bushings	_____ to _____ in. at			\$ _____
	Red'g	} Coupl'gs	} _____ to _____ in. at	_____	\$ _____
	Inc'g				
	Union	_____ in. at			\$ _____
	Meter	_____ in. at			\$ _____
					\$ _____
	Compound Joints	at			\$ _____
	Maintenance Foreman				\$ _____
	Hrs. Water Maint. Man-1	at			\$ _____
	Hrs. Water Maint. Man-2	at			\$ _____
	Hrs. Garage Foreman	at			\$ _____
	Hrs. Labor	at			\$ _____
	Hrs. Compressor	at			\$ _____
					\$ _____
	Trucking				\$ _____
	Pav't Patch				\$ _____
					\$ _____
					\$ _____
					\$ _____
					\$ _____

St. TT
 Ave. No. 14
 Name of Owner

CLOTHIER

Labor and Mat'l. Report OCT. 19 1936

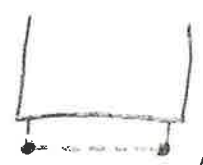

24 1/2" 15 1/2"
 ● Curb Box

4" Main Elev. of Main at tap 5'

Gate at ● Gate at ●

● Curb Box

OLD TAP SHUT OFF