

LABOR AND MATERIALS


1	Copper	Connection	$\frac{3}{4}$	\$
1	Curb	Cock Valve T.S. & V.	$\frac{3}{4}$ in.	\$
1	Service box	Short $3\frac{1}{2} \times 4\frac{1}{2}$		\$
	Old returned	Long $4\frac{1}{2} \times 5\frac{1}{2}$		\$
25	Ft.	Copper	Pipe at	\$
		$\frac{3}{4}$ in.		
	Nipples	in. at		\$
	Bushings	to in. at		\$
	Red'g			\$
	Inc'g	Coupl'gs to in. at		\$
	Union	in. at		\$
	Meter	in. at		\$
	Compound Joints	at		\$
	Maintenance Foreman			\$
	Hrs. Water Maint. Man-1	at		\$
	Hrs. Water Maint. Man-2	at		\$
	Hrs. Garage Foreman	at		\$
	Hrs. Labor	at		\$
	Hrs. Compressor	at		\$
	Trucking			\$
	Pav't Patch			\$
				\$
				\$
St. 11  
~~St.~~  
 Ave. No. 1

DIVISION

Name of Owner

Labor and Mat'l. Report NOV 13 19 33

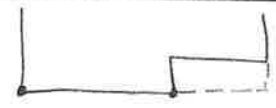

30'-2" 17'

● Curb Box

4" Main

Elev. of Main at tap 5 1/2'

Gate at ●

● Gate at

● Curb Box

OLD TAP SHUT OFF AT MAIN