

LABOR AND MATERIALS

1	Copper	{ Connection	3/4"		\$ 2.29
1	Curb	{ Cock Valve T.S. & V. }	3/4 in.		\$ 2.70
1	Service box Old returned	{ Short 3 1/2 x 4 1/2 Long 4 1/2 x 5 1/2 Buff or Rdway }			\$ 4.25
9	Ft. 3/4 in.	{ Copper G.I. G.I. }	Pipe at 35		\$ 3.15
	Nipples	in. at			\$
	Bushings	to in. at			\$
	Red'g Inc'g	{ Coupl'gs to in. at }			\$
	Union	in. at			\$
	Meter	in. at			\$
	Lead Joints	at			\$
	Compound Joints	at			\$
1	Hrs. Water Maint. Man-1	at			\$ 1.12
1	Hrs. Water Maint. Man-2	at			\$ 1.02
10	Hrs. Labor	at 91			\$ 9.10
	Hrs. Labor	at			\$
	Hrs. Compressor	at			\$
	Compensation Ins.	at \$ per C.			\$ 25
	Trucking				\$ 1.00
	Pav't Patch	B.P.			\$
	Tap by Wazinski				\$
	O'head				\$ 24.88

185-1950


Before Paving

St. _____
 Pt. _____
 Ave. No. 10-12

Division _____

Name of Owner _____
 Merton Wolcott

Labor and Mat'l. Report _____
 Aug 22, 19 50

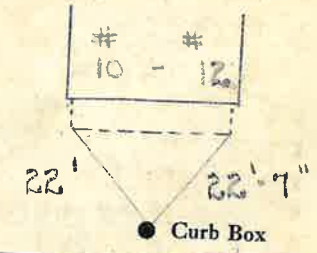

4" Main

Elev. of Main at tap 5'

Gate at ●

● Gate at

● Curb Box