

### Labor and Materials

3/4 3/4 3/4	Copper Lead	Connection		\$	1.46	
	Curb	Cock Valve T. S. & V.	in	\$	1.93	
/	Service Box Old returned	Short 3 1/2 x 4 1/2 Long 4 1/2 x 5 1/2		\$	1.77	
27	Ft.	Buff. or Railway		\$		
3/4	in.	Copper Galvanized Cast Iron	Pipe at	\$	5.94	
	Nipples	in. at		\$		
	Bushings	to in. at		\$		
	Red'g Inc'g	Couplings to in. at		\$		
	Union	in. at		\$		
	Meter	in. at		\$		
	Lead Joints	at		\$		
	Leadite Joints	at		\$		
	Hrs. Foreman	at		\$		
	Hrs. Chauffeur	at		\$		
9	Hrs. Tapper	at		\$	5.63	
10	Hrs. Labor	at		\$	4.50	
	Hrs. Labor	at		\$		
	Hrs. Compressor	at		\$		
	Compensation Ins.			\$	.31	
	Trucking			\$	1.00	
	Builders Use of Water	Batch		\$	5.00	
	Tap made by Hessel				\$	
					\$	
					\$	
					\$	27.54

9 3-1937


St. Ave. No. 13

*DIVISION*

Name of Owner

*Allen*

Labor and Mat'l. Report *Aug 17* 19*37*

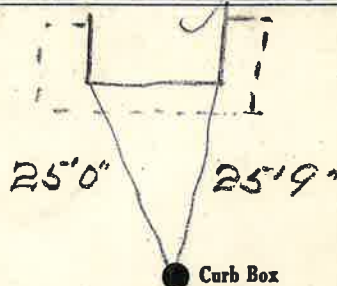

4"  
Main

Elev. of Main at tap *6'*

Gate at ●

● Gate at

● Curb Box

*old shut off*