

LABOR AND MATERIALS


1	Copper	{ Connection	3/4"	\$ 2.29
	Lead			
1	Curb	{ Cock Valve	3/4 in.	\$ 2.70
		{ T. S. & V.:		
1	Service box	{ Short 3 1/2 x 4 1/2		
	Old returned	{ Long 4 1/2 x 5 1/2		\$ 4.25
		{ Buff or Rdway		
9	Ft.	{ Copper		
	3/4 in.	{ G. I.	Pipe at	\$ 3.15
	Nipples	in. at		\$
	Bushings	to in. at		\$
	Red'g	{ Coupl'gs	to in. at	\$
	Inc'g			
	Union	in. at		\$
	Meter	in. at		\$
	Lead Joints	at		\$
	Compound Joints	at		\$
1	Hrs. Water Maint. Man	-1 at		\$ 1.12
1	Hrs. Water Maint. Man	-2 at		\$ 1.02
10	Hrs. Labor	at		\$ 9.10
	Hrs. Labor	at		\$
	Hrs. Compressor	at		\$
	Compensation Ins.	at \$ per C.		\$ 25
	Trucking			\$ 1.00
	Pav't Patch	B. P.		\$
	Tap by Warsinski			\$
	O'head			\$
				\$ 24.88

187-1950 Before Paving

St. Pt. Ave. No. 16

Division
Name of Owner
Mrs. Chas. Mitchell

Labor and Mat'l. Report Aug 22 1950

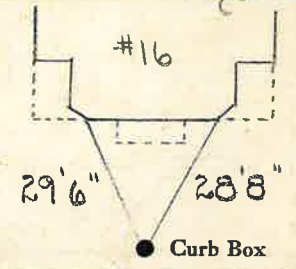

4" Main Elev. of Main at tap 5'

Gate at ● Gate at ●

● Curb Box