

LABOR AND MATERIALS


1	Copper Lead	{ Connection	3/4"	\$	2.29
1	Curb	{ Cock Valve F.S. & V.	3/4 in.	\$	2.70
1	Service box Old returned	{ Short 3 1/2 x 4 1/2 Long 4 1/2 x 5 1/2 Buff or Rdway		\$	4.25
60	Ft.	{ Copper G.I. G.I.	3/4 in. Pipe at	\$	2.10
	Nipples	in. at		\$	
	Bushings	to in. at		\$	
	Red'g Inc'g	{ Coupl'gs to in. at		\$	
	Union	in. at		\$	
	Meter	in. at		\$	
	Lead Joints	at		\$	
	Compound Joints	at		\$	
	Hrs. Water Maint. Man	1 at		\$	1.12
	Hrs. Water Maint. Man	2 at		\$	1.02
10	Hrs. Labor	at		\$	9.10
	Hrs. Labor	at		\$	
	Hrs. Compressor	at		\$	
	Compensation Ins.	at \$ per C.		\$	2.25
	Trucking			\$	1.25
	Pay't Patch	R.P.		\$	
	Tap by	Yarsinski		\$	
	O'head			\$	
				\$	23.93

18-20 Before Paving

Division \_\_\_\_\_ St. # \_\_\_\_\_ Ave. No. 18-20

Name of Owner  
Lura L. Lord

Labor and Mat'l. Report Aug 23 1950

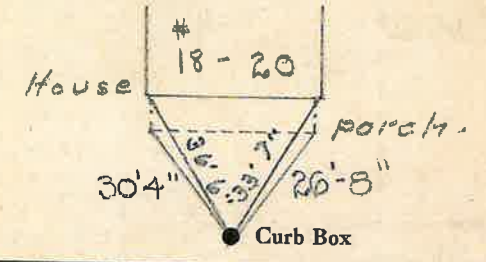

4" Main Elev. of Main at tap 5'

Gate at ● Gate at ●

● Curb Box