

LABOR AND MATERIALS

1	Copper Lead	} Connection $\frac{3}{4}$		\$ 1.35
1	Curb	{ Cock Valve I. S. & V. }	$\frac{3}{4}$ in.	\$ 1.80
1	Service Box Old returned	{ Short $3\frac{1}{2} \times 4\frac{1}{2}$ Long $4\frac{1}{2} \times 6\frac{1}{2}$ Buffer Rdway }		\$ 1.70
8	Ft. $\frac{3}{4}$ in.	{ Copper Galv Iron Cast Iron }	Pipe at l.f.	\$ 1.44
	Nipples		in. at	\$
	Bushings		to in. at	\$
	Red'g Inc'g	Couplings	to in. at	\$
	Union		in. at	\$
	Meter		in. at	\$
	Lead Joints		at	\$
	Leadite Joints		at	\$
	Hrs. Foreman		at	\$
3	Hrs. Chauffeur		at $6\frac{1}{2} hr$	\$ 1.88
	Hrs. Tapper		at	\$
12	Hrs. Labor		at 45	\$ 5.40
	Hrs. Labor		at	\$
	Hrs. Compressor		at	\$
	Compensation Ins.			\$ 1.23
	Trucking			\$ 1.00
	Builders Use of Water	$Patch$		\$ 5.00
	$Tap by P. H. O. H.$			\$
				\$
				\$
				\$ 19.80

26 1941

St.
-Pl.
Ave. No. 22

Division


Name of Owner

Primeau

Labor and Mat'l. Report

May 6

1941

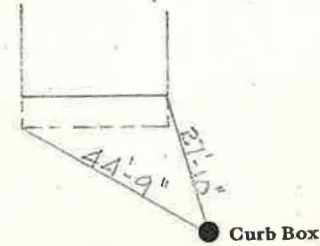

4 Main

Elev. of
Main at tap 5

Gate at ●

● Gate at

TAX ID # 309.27-4-5

● Curb Box