

LABOR AND MATERIALS

Copper	} Connection _____	in.	\$ _____	
Lead				
Curb	} Cock Valve } _____	in.	\$ _____	
				T. S. & V. }
Service box				{ Short 3½ x 4½ } _____
Old returned	{ Long 4½ x 5½ } _____			
	{ Buff or Rdway } _____			
8 Ft. 1½ in.	} Copper } _____	Pipe at _____	\$ _____	
				{ G.I. } _____
				{ C.I. } _____
Nipples	in. at _____		\$ _____	
Bushings	to _____ in. at _____		\$ _____	
Red'g	} Coupl'gs _____ to _____ in. at _____		\$ _____	
Inc'g				
Union	in. at _____		\$ _____	
Meter	in. at _____		\$ _____	
Lead Joints at _____			\$ _____	
Compound Joints at _____			\$ _____	
Maintenance Foreman _____			\$ _____	
Hrs. Water Maint. Man-1 at _____			\$ _____	
Hrs. Water Maint. Man-2 at _____			\$ _____	
Hrs. Garage Foreman _____ at _____			\$ _____	
Hrs. Labor _____ at _____			\$ _____	
Hrs. Compressor at _____			\$ _____	
Compensation Ins. at \$ _____ per C _____			\$ _____	
Trucking _____			\$ _____	
Pav't Patch _____			\$ _____	
_____			\$ _____	
_____			\$ _____	
_____			\$ _____	
O'head _____			\$ _____	
_____			\$ _____	

Division
Line


St. _____
Pt. _____
Ave. No. 17

Name of Owner

Iron Gate

Labor and Mat'l. Report

1986

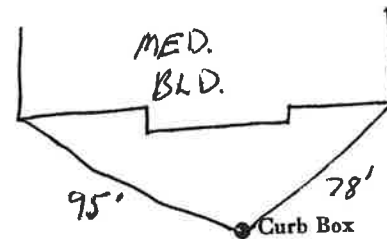

	Elev. of
Main	Main at tap
Gate at ●	● Gate at

● Curb Box

LABOR AND MATERIALS

Copper	} Connection	_____	\$ _____			
Lead						
Curb	} Cock Valve T. S. & V. }	_____ in.	\$ _____			
				Service box	{ Short 3½ x 4½ Long 4½ x 5½ Buff or Rdway }	_____ \$ _____
Ft. <u>4</u> in.	{ Copper G. I. C. I. }	Pipe at _____	\$ _____			
Nipples	_____ in.	at _____	\$ _____			
Bushings	_____ to _____	in. at _____	\$ _____			
Red'g	} Coupl'gs	_____ to _____	in. at _____ \$ _____			
Inc'g						
Union	_____ in.	at _____	\$ _____			
Meter	_____ in.	at _____	\$ _____			
Lead Joints	at _____		\$ _____			
Compound Joints	at _____		\$ _____			
Maintenance Foreman	_____		\$ _____			
Hrs. Water Maint. Man-1	at _____		\$ _____			
Hrs. Water Maint. Man-2	at _____		\$ _____			
Hrs. Garage Foreman	at _____		\$ _____			
Hrs. Labor	_____ at _____		\$ _____			
Hrs. Compressor	at _____		\$ _____			
Compensation Ins.	at \$ _____ per C.		\$ _____			
Trucking	_____		\$ _____			
Pav't Patch	_____		\$ _____			
			\$ _____			
			\$ _____			
			\$ _____			
O'head	_____		\$ _____			
			\$ _____			

St.
~~Pl.~~
Ave. No. _____


Division

Name of Owner

Arroyo Center

Labor and Mat'l. Report

1986

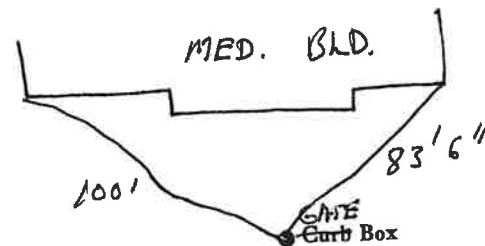

Main Elev. of
Main at tap _____

Gate at ● ● Gate at

● Curb Box