

LABOR AND MATERIALS

1	Copper Lead	{ Connection	3/4"	\$	2.29
1	Curb	{ Cock Valve T-S. & V. }	3/4 in.	\$	2.70
1	Service box Old returned	{ Short 3 1/2 x 4 1/2 Long 4 1/2 x 5 1/2 Buff or Rdway }		\$	4.25
2.1	Ft.	{ Copper C.I. C.I. }	3/4 in. Pipe at	35	\$ 7.35
	Nipples	in. at		\$	
	Bushings	to in. at		\$	
	Red'g Inc'g	{ Coupl'gs	to in. at	\$	
	Union	in. at		\$	
	Meter	in. at		\$	
	Lead Joints at			\$	
	Compound Joints at			\$	
4 1/2	Hrs. Water Maint. Man-1	at	1.12	\$	4.48
2	Hrs. Water Maint. Man-2	at	1.02	\$	2.04
	Hrs. Labor	at		\$	
12	Hrs. Labor	at	91	\$	10.92
	Hrs. Compressor at			\$	
	Compensation Ins. at \$	per C.		\$	39
	Trucking			\$	1.00
	Pav't Patch			\$	
	Tap by Warsinski			\$	
	O'head			\$	
				\$	34.03

150-1950


Before Paving

St. _____
Pt. _____
Ave. No. 3

Division _____

Name of Owner
Mrs Joseph N. Nolan

Labor and Mat'l. Report Aug 21 19 50

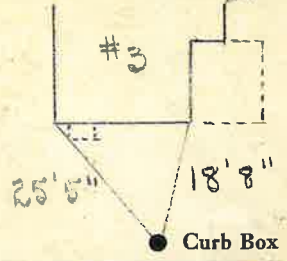

4" Main Elev. of Main at tap 5'
Gate at • Gate at

• Curb Box