


LABOR AND MATERIALS

1	Copper Lead	{ Connection	<u>3/4"</u>		\$	<u>2.29</u>
1	Curb	{ Cock Valve F.S. & V. }		in.	\$	<u>2.70</u>
1	Service box Old returned	{ Short $3\frac{1}{2} \times 4\frac{1}{2}$ Long $4\frac{1}{2} \times 5\frac{1}{2}$ Buff or Rdway }			\$	<u>4.25</u>
15	Ft. <u>3/4</u> in.	{ Copper G.I. G.I. }		Pipe at	\$	<u>35 5.25</u>
	Nipples		in.	at	\$	
1	Bushings	<u>3/4</u> to <u>1/2</u>		in. at G.I.	\$	
	Red'g Inc'g	{ Coupl'gs		to in. at	\$	
	Union		in.	at	\$	
	Meter		in.	at	\$	
	Lead Joints	at			\$	
	Compound Joints	at			\$	
1	Hrs. Water Maint. Man—1	at <u>1.12</u>			\$	<u>1.12</u>
1	Hrs. Water Maint. Man—2	at			\$	<u>1.07</u>
10	Hrs. Labor	at			\$	<u>9.10</u>
	Hrs. Labor	at			\$	
	Hrs. Compressor	at			\$	
	Compensation Ins. at \$	per C.			\$	<u>25</u>
	Trucking				\$	<u>1.</u>
	Pav't Patch	<u>B.P.</u>			\$	
	<u>Tap by Warsinski</u>				\$	
	O'head				\$	
					\$	
					\$	
					\$	<u>26.98</u>

183-1950 Before Paving

Division _____ St. _____
 Ave. No. 6
 Name of Owner
Thomas Lane Est

Labor and Mat'l. Report Aug 21 19 50

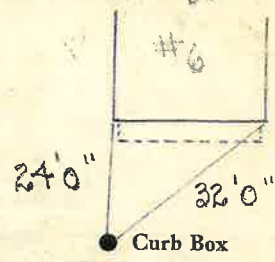

4" Main Elev. of Main at tap 05'
 Gate at ● Gate at ●

● Curb Box