


LABOR AND MATERIALS

1 Copper } Connection $\frac{3}{4}$ in. \$ _____
 -Lead }
 1 Curb } Cock Valve } $\frac{3}{4}$ in. \$ _____
 } P.S. & V. }
 Service box } Short $3\frac{1}{2} \times 4\frac{1}{2}$ }
 Old returned } Long $4\frac{1}{2} \times 5\frac{1}{2}$ } \$ _____
 20 Ft. $\frac{3}{4}$ in. { Copper } Pipe at \$ _____
 { C.P. }
 { G.I. }
 Nipples _____ in. at \$ _____
 Bushings _____ to _____ in. at \$ _____
 Red'g }
 Inc'g } Coupl'gs _____ to _____ in. at \$ _____
 Union _____ in. at \$ _____
 Meter _____ in. at \$ _____
 _____ \$ _____
 Compound Joints at \$ _____
 Maintenance Foreman \$ _____
 Hrs. Water Maint. Man—1 at \$ _____
 Hrs. Water Maint. Man—2 at \$ _____
 Hrs. Garage Foreman _____ at \$ _____
 Hrs. Labor— _____ at \$ _____
 Hrs. Compressor at \$ _____
 _____ \$ _____
 Trucking _____ \$ _____
 Pav't Patch _____ \$ _____
 _____ \$ _____
 _____ \$ _____
 _____ \$ _____
 _____ \$ _____

DIVISION _____ St. _____
 No. 7

Name of Owner _____
 TAX ID # 302.20-25-2

Labor and Mat'l. Report JUNE 8 1928

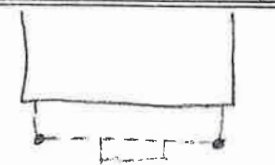

23'2" 23'7"

● Curb Box

4" Main Elev. of Main at tap 5'
 Gate at ● Gate at

● Curb Box

OLD TAP DISCONNECTED