

LABOR AND MATERIALS

1 Copper Lead	} Connection	3/4			
				\$	1.35
1 Curb	{ Cock Valve F.S. & V.	3/4	in.	\$	1.80
1 Service Box Old returned	{ Short 3 1/2 x 4 1/2 Long 4 1/2 x 5 1/2 Buffer-Roway			\$	1.70
33 Ft.	3/4 in.	{ Copper Galvanized Cast Iron	} Pipe at	19	\$ 5.94
Nipples	in. at			\$	
Bushings	to in. at			\$	
Red'g Inc'g	{ Couplings	to	in. at	\$	
Union	in. at			\$	
Meter	in. at			\$	
Lead Joints	at			\$	
Leadite Joints	at			\$	
Hrs. Foreman	at			\$	
3 1/4 Hrs. Chauffeur	at	6 2 1/2		\$	2.03
6 1/4 Hrs. Tapper	at	7		\$	3.90
23 1/4 Hrs. Labor	at	45		\$	10.46
Hrs. Labor	at			\$	
1 Hrs. Compressor	at			\$	63
Compensation Ins.				\$	50
Trucking				\$	1.-
Builders Use of Water	Before Paving			\$	
<i>Taply Hessel</i>					
					\$ 29.31

134 1941

-St-

-Pl-

Ave. No. 22


Dix

Name of Owner

Cannon (Katherine)

Labor and Mat'l. Report

Oct 10 1941

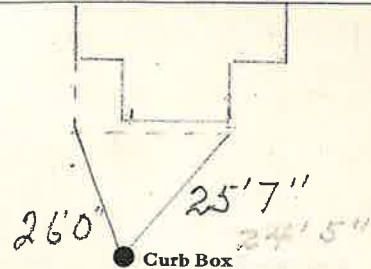

4" Main

Elev. of Main at tap 5'

Gate at ●

● Gate at

● Curb Box