


LABOR AND MATERIALS

1	Copper Issue	Connection	$\frac{3}{4}$ "	\$
1	Curb	Cock Valve T. S. & V.	$\frac{3}{4}$ " in.	\$
1	Service box Old returned	Short $3\frac{1}{2}$ x $4\frac{1}{2}$ Long $4\frac{1}{2}$ x $5\frac{1}{2}$		\$
12	Ft. $\frac{3}{4}$ in.	Copper SP. CP.	Pipe at	\$
	Nipples	in. at		\$
1	Bushings	$\frac{3}{4}$ " to $\frac{1}{2}$ " in. at		\$
1	Red'g Inch'g	Coupl'gs	BRASS to in. at	\$
	Union	in. at		\$
	Meter	in. at		\$
	Compound Joints	at		\$
	Maintenance Foreman			\$
	Hrs. Water Maint. Man—1	at		\$
	Hrs. Water Maint. Man—2	at		\$
	Hrs. Garage Foreman	at		\$
	Hrs. Labor	at		\$
	Hrs. Compressor	at		\$
	Trucking			\$
	Pav't Patch			\$
				\$
				\$
				\$
				\$

DIX Ave. No. 23

Name of Owner

Labor and Mat'l. Report APR. 24 1926

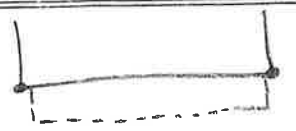

27 $\frac{1}{2}$ " 23 $\frac{5}{8}$ "

● Curb Box

4" Main Elev. of Main at tap 4'

Gate at ● ● Gate at

● Curb Box