


LABOR AND MATERIALS

1	Copper	} Connection	$\frac{3}{4}$	\$	_____	
1	Curb		} Cock Valve T.S. & V.	$\frac{3}{4}$ in.	\$	_____
	Service box	} { Short $3\frac{1}{2} \times 4\frac{1}{2}$ } } { Long $4\frac{1}{2} \times 5\frac{1}{2}$ }			\$	_____
	Old returned				\$	_____
31	Ft.	} { Copper } } { G.I. } } { G.I. }	$\frac{3}{4}$ in.	Pipe at	\$	_____
	Nipples			in. at	\$	_____
	Bushings		to _____ in. at	\$	_____	
	Red'g } Inc'g }	} Coupl'gs	to _____ in. at	\$	_____	
	Union			in. at	\$	_____
	Meter		in. at	\$	_____	
				\$	_____	
	Compound Joints		at	\$	_____	
	Maintenance Foreman			\$	_____	
	Hrs. Water Maint. Man-1		at	\$	_____	
	Hrs. Water Maint. Man-2		at	\$	_____	
	Hrs. Garage Foreman		at	\$	_____	
	Hrs. Labor		at	\$	_____	
	Hrs. Compressor		at	\$	_____	
				\$	_____	
	Trucking			\$	_____	
	Pav't Patch			\$	_____	
				\$	_____	
				\$	_____	
DIX ~~St.~~ Ave. No. 8
~~St.~~
 Name of Owner _____

Labor and Mat'l. Report APR. 30 19 31

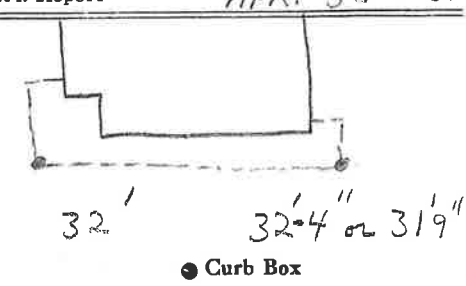

4" Main Elev. of Main at tap 4\frac{1}{2}'
 Gate at • Gate at

• Curb Box