


LABOR AND MATERIALS

1	Copper	Connection	$\frac{3}{4}$	\$
1	Curb	Cock	$\frac{3}{4}$ in.	\$
1	Service box	Sheet $3\frac{1}{2} \times 4\frac{1}{2}$		
	Old returned	Long $4\frac{1}{2} \times 5\frac{1}{2}$		\$
31	Ft.	Copper	Pipe at	\$
		$\frac{3}{4}$ in.		
	Nipples	in. at		\$
	Bushings	to in. at		\$
	Red'g			
	Inc'g	Coupl'gs to in. at		\$
	Union	in. at		\$
	Meter	in. at		\$
	Compound Joints	at		\$
	Maintenance Foreman			\$
	Hrs. Water Maint. Man—1	at		\$
	Hrs. Water Maint. Man—2	at		\$
	Hrs. Garage Foreman	at		\$
	Hrs. Labor—	at		\$
	Hrs. Compressor	at		\$
	Trucking			\$
	Pav't Patch			\$
				\$
				\$
DIX 56
22
Ave. No. 26

Name of Owner

Labor and Mat'l. Report JUNE 16 1933

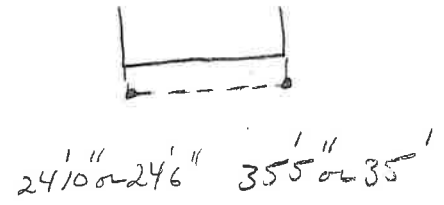

● Curb Box

6" Main Elev. of
Main at tap 5'

Gate at ● ● Gate at

● Curb Box

OLD TAP SHUT OFF