

## LABOR AND MATERIALS

1. <del>Lead</del> Copper Connection $\frac{3}{4}$ .....	\$ 2.94
1. Curb <del>Valve</del> $\frac{3}{4}$ in. <del>T. S. &amp; V.</del> .....	\$ 3.71
1. Service box <del>Old returned</del> { Short $3\frac{1}{2} \times 4\frac{1}{2}$ Long <del>4</del> $\times 5\frac{1}{2}$ Buff or Redway }.....	\$ 5.90
45 Ft. $\frac{3}{4}$ in. <del>Curb</del> <del>Curb</del> { Copper } Pipe at 30.....	\$ 13.50
Nipples..... in. at.....	\$.....
Bushings..... to..... in. at.....	\$.....
Red'g Inc'g { Coupl'gs..... to..... in. at.....	\$.....
Union..... in. at.....	\$.....
Meter..... in. at.....	\$.....
Lead Joints at.....	\$.....
Compound Joints at.....	\$.....
1. Hrs. Water Maint. Man-1 at.....	\$ 1.01
4. Hrs. Water Maint. Man-2 at 91.....	\$ 3.64
8. Hrs. Labor..... at..... 80.....	\$ 6.40
Hrs. Labor..... at.....	\$.....
2. Hrs. Compressor at..... 1:20.....	\$ 2.40
Compensation Ins. at \$..... per C.....	\$ 24
Trucking.....	\$ 1.00
Pav't Patch.....	\$ 26.70
Tap by Warsinske.....	\$.....
O'head.....	\$.....
	\$ 67.44

59

Dix


Ave. No. 44

Name of Owner

Goering Motor Co

Labor and Mat'l. Report

May 19 1948

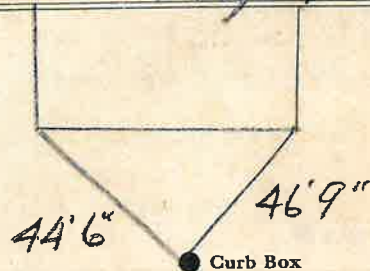

6" Main

Elev. of Main at tap 5'

Gate at ●

● Gate at

● Curb Box