

St. \_\_\_\_\_  
 Pl. \_\_\_\_\_  
 Ave. No. 52


Name of Owner

Lebowitz Bros.

Labor and Mat'l. Report

Aug. 30 19 61.

House  
 Moved  
 To Byrne  
 Ave. 33'2"  
see below

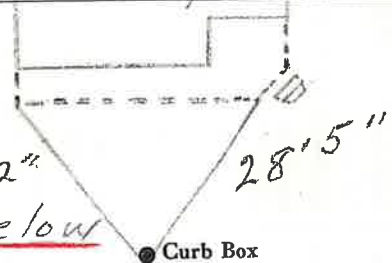


6" Main

Elev. of  
 Main at tap 5'

Gate at ●

● Gate at

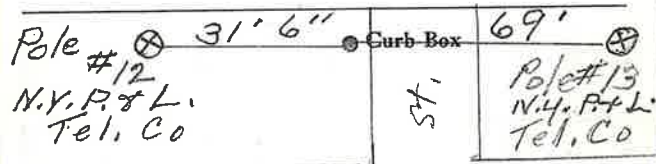

Dix Ave.

Cooper St.

LSM-BC-3-10-61

LABOR AND MATERIALS

1	Copper Lead	Connection	<u>3/4"</u>	\$
1	Curb	Cock Valve T.S. & V.	<u>3/4" in.</u>	\$
1	Service box Old returned	Short 3 1/2 x 4 1/2 Long 4 1/2 x 5 1/2 Buff or Rdway		\$
33	Ft. <u>3/4" in.</u>	Copper C.I. C.I.	Pipe at	\$
	Nipples	in. at		\$
	Bushings	to in. at		\$
	Red'g Inc'g	Coupl'gs to in. at		\$
	Union	in. at		\$
	Meter	in. at		\$
	Lead Joints	at		\$
	Compound Joints	at		\$
	Maintenance Foreman			\$
	Hrs. Water Maint. Man-1	at		\$
	Hrs. Water Maint. Man-2	at		\$
	Hrs. Garage Foreman	at		\$
	Hrs. Labor	at		\$
	Hrs. Compressor	at		\$
	Compensation Ins. at \$	per C		\$
	Trucking			\$
	Pav't Patch			\$
	Tap by Gissard			\$
	Car. 8-30-61			\$
	O'head			\$