

Labor and Materials

1	Copper } Connection ^{3/4}	\$
1	Lead } Connection ^{3/4}	\$
1	Curb } Cock Valve } ^{3/4} in.	\$
	T-S & V. }	
7	Service Box } Short 3/4x1/2 }	\$
	Old returned } Long 4 1/2x5 1/2 }	
		Buff. or Rdway }
12	Ft. ^{3/4} in. } Copper } Pipe at	\$
		Galv. Iron }
		Cast Iron }
	Nipples..... in. at	\$
	Bushings..... to..... in. at	\$
	Red'g } Couplings..... to..... in. at	\$
	Inc'g }	
	Union..... in. at	\$
	Meter..... in. at	\$
	Lbs. Br. Stone at	\$
	Lbs. Sand at	\$
	Bags Cement at	\$
	Paving Brick } Mack } at	\$
		Red }
		Asphalt }
	Lead Joints at	\$
	Leadite Joints at	\$
20	Hrs. Foreman at ^{6 2/3}	\$ 12.50
19	Hrs. Common Labor at ^{60 1/2}	\$ 7.72
	Hrs. Common Labor at	\$
	Hrs. Mason at	\$
	Hrs. Mason's Helper at	\$
	Hrs. Compressor at	\$
	Compensation Ins..... ⁵²	\$
	Trucking.....	\$
	Builders' Use of Water.....	\$
	Total \$	

57 Dix

Labor and Material Report


July 25

1928

at top of Playground Dig 46 ft



6" Main Elev of Main at tap 4 1/2

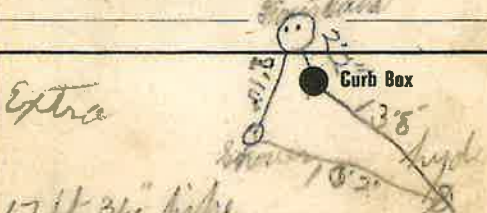

- Extra
- 17 ft 3/4 pipe
 - 1- tee 3/4"
 - 2- Elbs 3/4"
 - 2- stop + Waste 3/4"
 - 3- nips 3/4"
 - 6 ft 1/2" pipe
 - 5 ft 3/8 "
 - 1- " nips
 - 1- " unions