

LABOR AND MATERIALS


1 Copper } Connection 3/4" \$ _____
 Lead }
 1 Curb } Cook } 3/4 in. Oriseal \$ _____
 Valve }
 T. G. & V. }
 1 Service box { Short 3 1/2 x 4 1/2 }
 Old returned { Long 4 1/2 x 5 1/2 }
 Buff. or Rdway } \$ _____
 37 Ft. 3/4 in. { Copper } Pipe at \$ _____
 { G.I. }
 { G.I. }
 Nipples in. at \$ _____
 Bushings to in. at \$ _____
 Red'g }
 Inc'g } Coupl'gs to in. at \$ _____
 Union in. at \$ _____
 Meter in. at \$ _____
 Lead Joints at \$ _____
 Compound Joints at \$ _____
 Maintenance Foreman \$ _____
 Hrs. Water Maint. Man—1 at \$ _____
 Hrs. Water Maint. Man—2 at \$ _____
 Hrs. Garage Foreman at \$ _____
 Hrs. Labor— at \$ _____
 Hrs. Compressor at \$ _____
 Compensation Ins. at \$ _____ per C \$ _____
 Trucking \$ _____
 Pav't Patch \$ _____
 Tap by Gizzard & Co. \$ _____
 _____ \$ _____
7-5-67 \$ _____
 _____ \$ _____
 O'head \$ _____
 _____ \$ _____

St. _____
 Pl. _____
 Ave. No. 58

Dix

Name of Owner
Duplex Const. Co.

Labor and Mat'l. Report July 5 19 67

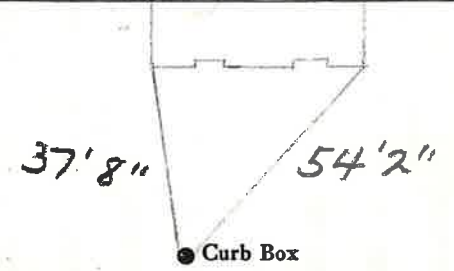

6" Main Elev. of Main at top 5'
 Gate at • Gate at

• Curb Box