


LABOR AND MATERIALS

1	Copper	} Connection $\frac{3}{4}$	\$
	<del>Lead</del>		
1	Curb	} Cock Valve T.S. & V. } $\frac{3}{4}$ in.	\$
1	Service box	} Short $3\frac{1}{2} \times 4\frac{1}{2}$ Long $4\frac{1}{2} \times 5\frac{1}{2}$ }	\$
	Old returned		
28	Ft. $\frac{3}{4}$ in.	} Copper <del>Gal.</del> <del>Gal.</del> }	Pipe at \$
	Nipples	in. at	\$
	Bushings	to in. at	\$
	Red'g Inc'g } Coupl'gs	to in. at	\$
	Union	in. at	\$
	Meter	in. at	\$
			\$
	Compound Joints	at	\$
	Maintenance Foreman		\$
	Hrs. Water Maint. Man—1	at	\$
	Hrs. Water Maint. Man—2	at	\$
	Hrs. Garage Foreman	at	\$
	Hrs. Labor—	at	\$
	Hrs. Compressor	at	\$
			\$
	Trucking		\$
	Pav't Patch		\$
			\$
			\$
St. DIX  
 Ave. No. 70  
 Name of Owner \_\_\_\_\_

Labor and Mat'l. Report SEPT. 19 19 29

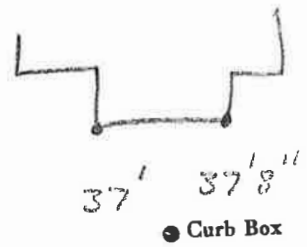

12" Main (1958) Elev. of Main at tap 5'  
 Gate at • Gate at •

TAX ID # 303.13-14-6

OLD TAP DISCONNECTED