

LABOR AND MATERIALS


1 Copper } Connection 1 1/2" \$ _____
 Lead }
 1 Curb } Cock } 2 in. \$ _____
 } Valve }
 } T.S. & V. }
 1 Service box { Short 3 1/2 x 4 1/2 }
 Old returned { Long 4 1/2 x 5 1/2 } \$ _____
 { Buff or Rdway }
 24 Ft. 2 in. { Copper } Pipe at \$ _____
 { G.I. }
 { C.I. }
 Nipples _____ in. at \$ _____
 Bushings _____ to _____ in. at \$ _____
 Red'g }
 Inc'g } Coupl'gs _____ to _____ in. at \$ _____
 1 Union 2 in. at \$ _____
 Meter _____ in. at \$ _____
 Lead Joints at \$ _____
 Compound Joints at \$ _____
 Maintenance Foreman \$ _____
 Hrs. Water Maint. Man-1 at \$ _____
 Hrs. Water Maint. Man-2 at \$ _____
 Hrs. Garage Foreman _____ at \$ _____
 Hrs. Labor _____ at \$ _____
 Hrs. Compressor at \$ _____
 Compensation Ins. at \$ _____ per C \$ _____
 Trucking \$ _____
 Pav't Patch \$ _____
Tap by Beecher + Co \$ _____
June 27, 1978 \$ _____
 O'head \$ _____

St
 PL
 Ave. No. 86

Dix

Name of Owner
Emmanuel Pissare

Labor and Mat'l. Report June 27 1978

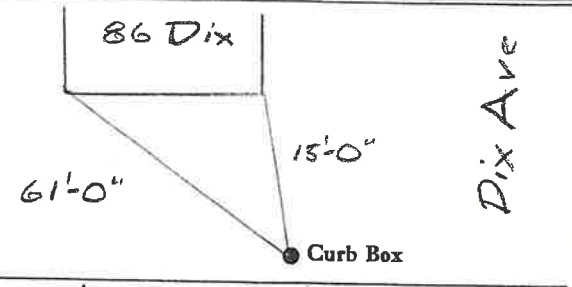

Uncas St
6" Main Elev. of Main at tap 5'

Gate at • Gate at

• Curb Box
Tap on Uncas St.

Vok
 LSM-5C-6-1-67