

LABOR AND MATERIALS

1	Copper Lead	Connection	3/4		\$ 1.23
1	Curb	Cock Valve T-S & V	3/4 in.		\$ 1.68
1	Service Box Old returned	Short 3 1/2 x 4 1/2 Long 4 1/2 x 5 1/2 Buff. or Rdway			\$ 1.54
11	Ft.	3/4 in.		Copper Galv-iron Cast-iron	Pipe at \$ 1.87
	Nipples	in. at			\$
	Bushings	to in. at			\$
	Red'g Inc'g	Couplings	to in. at		\$
	Union	in. at			\$
	Meter	in. at			\$
	Lead Joints	at			\$
	Leadite Joints	at			\$
	Hrs. Foreman	at			\$
7	Hrs. Chauffeur	at	6 1/2 hr		\$ 4.38
2	Hrs. Tapper	at	"		\$ 5.00
1	Hrs. Flk	at	.50		\$.50
	Hrs. Labor	at			\$
1	Hrs. Compressor	at			\$
	Compensation Ins.				\$ 3.00
	Trucking				\$ 1.00
	Builders Use of Water				\$
	Tap by Hassel				\$
	Patch 1/2 Sewer Dept.				\$ 2.50
					\$
					\$ 20.00

11 - 1939

St.
Pk.

Dix

Ave. No. 105


Name of Owner:

LeFebvre

Labor and Mat'l. Report

Nov 13

1939

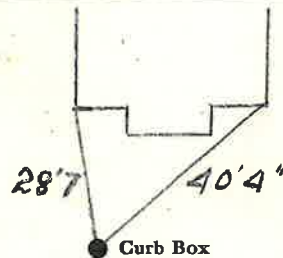

6" Main Elev. of Main at tap 5'

Gate at ● ● Gate at

● Curb Box

New 11/13/39