

# LABOR AND MATERIALS

1	Copper Lead } Connection	3/4	\$	1.35
1	Curb } Cock Valve } T. G. & V. }	3/4 in.	\$	1.80
1	Service Box Old returned	{ Short 3 1/2 x 4 1/2 } { Long 4 1/2 x 5 1/2 } { Buffer Rdway }	\$	1.70
13	Ft. 3/4 in.	{ Copper Galv Iron } { Cast Iron }	Pipe at 18	\$ 2.34
	Nipples	..... in. at	\$	
	Bushings	..... to ..... in. at	\$	
	Red'g Inc'g } Couplings	..... to ..... in. at	\$	
	Union	..... in. at	\$	
	Meter	..... in. at	\$	
	Lead Joints at		\$	
	Leadite Joints at		\$	
	Hrs. Foreman at		\$	
1	Hrs. Chauffeur at	6 1/2	\$	63
2 1/2	Hrs. Tapper at	7	\$	1.56
9 1/2	Hrs. Labor at	45	\$	4.28
	Hrs. Labor at		\$	
	Hrs. Compressor at		\$	
	Compensation Ins.		\$	20
	Trucking		\$	1-
	Builders Use of Water	Before Pumping	\$	
	Truck by Boss of		\$	
			\$	
			\$	
			\$	14.86

129 1941

St.  
Pl.  
Ave. No. 11

Dix


Name of Owner

Lee Author

Labor and Mat'l. Report

Oct 10

1941

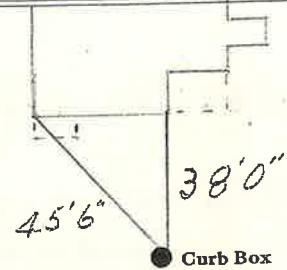

4" Main

Elev. of Main at tap 5'

Gate at ●

● Gate at

● Curb Box