

LABOR AND MATERIALS

1	Copper / Connection	$\frac{3}{4}$	\$	2.87
	Lead			
1	Curb Valve	$\frac{3}{4}$ in.	\$	3.62
	T. S. & V.			
1	Service box	Short $3\frac{1}{2} \times 4\frac{1}{2}$		4.68
	Old returned	Long $4\frac{1}{2} \times 5\frac{1}{2}$		
		Buff or Rdway		
45	Ft. $\frac{3}{4}$ in.	Copper	Pipe at	32
		C.I.		
		C.I.		14.40
	Nipples	in. at	\$	
1	Bushings	$\frac{3}{4}$ " to <i>Complin</i>	in. at	18
	Red'g			
	Inc'g	Coupl'gs	to	in. at
5	Union	3" in.	at	<i>Dynalite</i>
				50
8	Meter	<i>Dynalite</i>	at	<i>Caps</i>
				1.50
	Lead Joints	at	\$	
	Compound Joints	at	\$	
14 1/2	Hrs. Water Maint. Man-1	at	1.12	\$ 16.24
23	Hrs. Water Maint. Man-2	at	1.02	\$ 23.46
60	Hrs. Labor	at	91	\$ 54.60
	Hrs. Labor	at	\$	
10	Hrs. Compressor	at	1.20	\$ 12.00
	Compensation Ins.	at \$ 2.18 per C		\$ 2.06
	Trucking			\$ 2.02
	Pav't Patch			\$ 10.25
	<i>T. cap. by M. L. L.</i>			
	O'head		\$	
				\$ 148.36

92


St. _____
 Pt. _____
 Ave. No. 106

Name of Owner

Bolstary

Labor and Mat'l. Report

Sept 9 1949

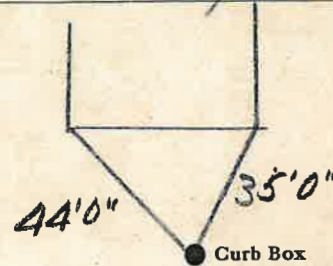

6" Main

Elev. of Main at tap 5'

Gate at ●

● Gate at

TAX ID # 303.13-15-19

● Curb Box