

LABOR AND MATERIALS

Copper } Connection _____ \$ _____
 Lead }
 Curb } Cock } _____ in. \$ _____
 } Valve }
 } T. S. & V. }
 Service box { Short 3½ x 4½ }
 Old returned { Long 4½ x 5½ } _____ \$ _____
 8 Ft. ¾ in. { Copper } Pipe at _____ \$ _____
 { G.I. }
 { G.I. }
 Nipples _____ in. at _____ \$ _____
 Bushings _____ to _____ in. at _____ \$ _____
 Red'g }
 Inc'g } Coupl'gs _____ to _____ in. at _____ \$ _____
 Union _____ in. at _____ \$ _____
 Meter _____ in. at _____ \$ _____
 _____ \$ _____
 Compound Joints at _____ \$ _____
 Maintenance Foreman _____ \$ _____
 Hrs. Water Maint. Man—1 at _____ \$ _____
 Hrs. Water Maint. Man—2 at _____ \$ _____
 Hrs. Garage Foreman _____ at _____ \$ _____
 Hrs. Labor— _____ at _____ \$ _____
 Hrs. Compressor at _____ \$ _____
 _____ \$ _____
 Trucking _____ \$ _____
 Pav't Patch _____ \$ _____
 _____ \$ _____
 _____ \$ _____
 _____ \$ _____
 _____ \$ _____

DIX


St. _____
 Pt. _____
 Ave. No. 119

Name of Owner

GIRARD - CPA OFFICE

Labor and Mat'l. Report

1983

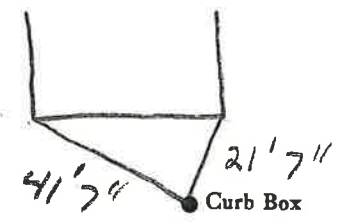

12" Main

Elev. of Main at tap 6'

Gate at ●

● Gate at

● Curb Box