

LABOR AND MATERIALS

Copper } Connection _____	\$ _____
Lead } _____	\$ _____
Curb } Cock _____	in. \$ _____
} Valve _____	
} T.S. & V. _____	
Service box } Short 3½ x 4½ }	
Old returned } Long 4½ x 5½ }	\$ _____
35 Ft. 3/4 in. } Copper } Pipe at _____	\$ _____
} G.I. }	
} C.I. }	
Nipples _____ in. at _____	\$ _____
Bushings _____ to _____ in. at _____	\$ _____
Red'g } _____	
Inc'g } Coupl'gs _____ to _____ in. at _____	\$ _____
Union _____ in. at _____	\$ _____
Meter _____ in. at _____	\$ _____
_____	\$ _____
Compound Joints at _____	\$ _____
Maintenance Foreman _____	\$ _____
Hrs. Water Maint. Man—1 at _____	\$ _____
Hrs. Water Maint. Man—2 at _____	\$ _____
Hrs. Garage Foreman _____ at _____	\$ _____
Hrs. Labor— _____ at _____	\$ _____
Hrs. Compressor at _____	\$ _____
_____	\$ _____
Trucking _____	\$ _____
Pav't Patch _____	\$ _____
_____	\$ _____
_____	\$ _____
_____	\$ _____
_____	\$ _____

DIX


St. Ave. No. 130

Name of Owner

TAX ID # 303.14-1-5

Labor and Mat'l. Report

19 92

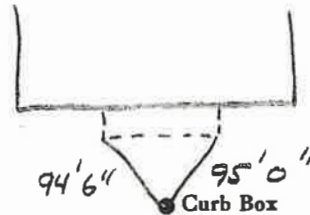

_____ Main	Elev. of Main at tap _____
Gate at ●	● Gate at
_____	_____
_____	● Curb Box

TIES FROM PORCH POSTS

TAP ON DIX AVE.