


LABOR AND MATERIALS

1 Copper } Connection 3/4" \$  
 Lead }  
 1 Curb } Cock } 3/4 in. (MARK II) \$  
 Valve } (ORISEAL)  
 T.S. & V. }  
 1 Service box { Short 3 1/2 x 4 1/2 }  
 Old returned { Long 4 1/2 x 5 1/2 } \$  
 { Buff. or Rdway. }  
 32 3/4 in. { Copper } Pipe at \$  
 { C.I. }  
 { C.I. }  
 Nipples in. at \$  
 Bushings to in. at \$  
 Red'g }  
 Inc'g } Coupl'gs. to in. at \$  
 Union in. at \$  
 Meter in. at \$  
 1 Lead Joints at 3/4" Male Adapter \$  
 Compound Joints at \$  
 Maintenance Foreman \$  
 Hrs. Water Maint. Man-1 at \$  
 Hrs. Water Maint. Man-2 at \$  
 Hrs. Garage Foreman at \$  
 Hrs. Labor at \$  
 Hrs. Compressor at \$  
 Compensation Ins. at \$ per C \$  
 Trucking \$  
 Pav't Patch \$  
 Tap made by Beecher \$  
 O'head Nov. 28-1973 \$  
 \$  
 \$

Dix St. 12  
 Ave. No. 12  
 Name of Owner  
Thos. R. Brayton

Labor and Mat'l. Report Nov. 28 1973

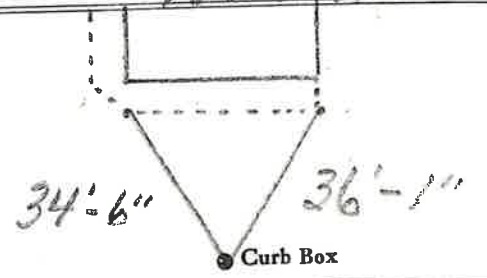

4" Main Elev. of Main at tap 5'  
 Gate at • Gate at •

• Curb Box