

LABOR AND MATERIALS

1	Copper Lead	Connection	$\frac{3}{4}$ "	\$
1	Curb	Cock Valve T.S. & V.	$\frac{3}{4}$ " in.	\$
1	Service box Old returned	{ Short $3\frac{1}{2} \times 4\frac{1}{2}$ Long $4\frac{1}{2} \times 5\frac{1}{2}$ }		\$
34'6"	$\frac{3}{4}$ in.	{ Copper Gal. Gal. }	Pipe at	\$
	Nipples	in. at		\$
	Bushings	to in. at		\$
1	Redg. Inc'g	Coupl'gs	to in. at	\$
	Union	in. at		\$
	Meter	in. at		\$
				\$
	Compound Joints	at		\$
	Maintenance Foreman			\$
	Hrs. Water Maint. Man—1	at		\$
	Hrs. Water Maint. Man—2	at		\$
	Hrs. Garage Foreman	at		\$
	Hrs. Labor—	at		\$
	Hrs. Compressor	at		\$
				\$
	Trucking			\$
	Pav't Patch			\$
				\$
				\$
				\$
				\$

DIX


32

Ave. No. 138

Name of Owner

Labor and Mat'l. Report

MARCH 29 1928

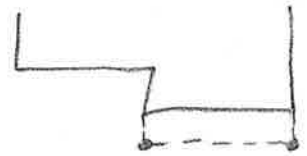

36 1/2" 27 6/8"

● Curb Box

12"

Main

Elev. of

Main at tap

Gate at ●

● Gate at

● Curb Box