

LABOR AND MATERIALS

| | | | | |
|----|---------------------------------|--|----|--------|
| 1 | Copper Lead Connection | 3/4" | \$ | 2.76 |
| 1 | Curb Cock Valve T.S. & V. | 3/4 in. | \$ | 3.49 |
| 1 | Service box Old returned | Short 3 1/2 X 4 1/2 Long 4 1/2 X 5 1/2 Buff or Rdway | \$ | 4.75 |
| 45 | Ft. 3/4 in. Copper C.I. Pipe at | 35 | \$ | 15.75 |
| | Nipples | in. at | \$ | |
| | Bushings | to in. at | \$ | |
| 1 | Red'g Ine'g Coupl'gs | cap to cap 3/4 in. at | \$ | ? |
| | Union | in. at | \$ | |
| | Meter | in. at | \$ | |
| | Lead Joints at | | \$ | |
| 22 | Compound Joints at | man 1.44 | \$ | 31.68 |
| 33 | Hrs. Water Maint. Man-1 at | 1.34 | \$ | 44.22 |
| | Hrs. Water Maint. Man-2 at | | \$ | |
| 88 | Hrs. Labor- at | 1.13 | \$ | 99.44 |
| | Hrs. Labor- at | | \$ | |
| 4 | Hrs. Compressor at | 1.50 | \$ | 6.00 |
| | Compensation Ins. at | \$3.706 per C. | \$ | 6.50 |
| | Trucking | | \$ | 1.00 |
| | Pav't Patch | | \$ | 31.50 |
| | Tap by Waisinski | | \$ | |
| | 7-29-52 | | \$ | |
| | O'head | | \$ | |
| | | | \$ | 247.09 |

215.59


Dix

St. Ave. No. 142

Name of Owner

Moriarty

Labor and Mat'l. Report July 29 1952

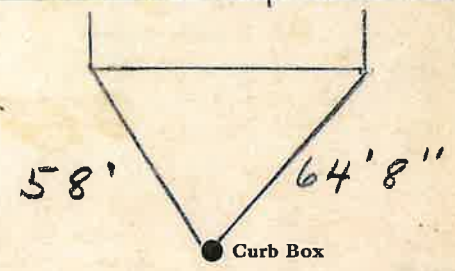

12" Main

Elev. of Main at tap 6'

Gate at ●

● Gate at

● Curb Box