

LABOR AND MATERIALS


1	Copper	Connection	3/4"	\$
1	Lead	Cock	3/4 in.	\$
1	Curb	Valve		\$
		T. S. & V.		\$
1	Service box	Short 3 1/2 x 4 1/2		\$
	Old returned	Long 4 1/2 x 5 1/2		\$
		Buff or Rdway		\$
35	3/4 in.	Copper	Pipe at	\$
		C.I.		\$
		C.I.		\$
	Nipples	in. at		\$
	Bushings	to in. at		\$
	Red'g			\$
	Inc'g	Coupl'gs to in. at		\$
	Union	in. at		\$
	Meter	in. at		\$
	Lead Joints at			\$
	Compound Joints at			\$
	Maintenance Foreman			\$
	Hrs. Water Maint. Man-1 at			\$
	Hrs. Water Maint. Man-2 at			\$
	Hrs. Garage Foreman at			\$
	Hrs. Labor— at			\$
	Hrs. Compressor at			\$
	Compensation Ins. at \$ per C.			\$
	Trucking			\$
	Pav't Patch			\$
	Tap by GLEFFORD			\$
	3-25-58			\$
	O'head			\$
				\$

✓ Warner Auto Electric

Dix St. No. 144
Pl. Ave. No. 144

Name of Owner CHEVION
Bray Oil Co, Gas Sta.

Labor and Mat'l. Report Mar. 25 19 58

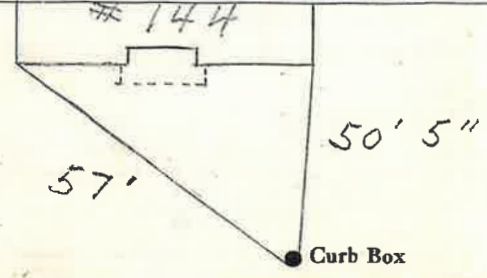

12" Main Elev. of Main at tap 6"

Gate at • Gate at

TAX ID #303.14-1-13

• Curb Box