

LABOR AND MATERIALS

Copper } Connection		\$
Lead } Connection		\$
Curb } Cock Valve T. S. & V. }	in.	\$
Service box } Short 3 1/2 x 4 1/2 }		\$
Old returned } Long 4 1/2 x 5 1/2 }		\$
Ft. 2 in. } Copper }	Pipe at	\$
Nipples	in. at	\$
Bushings	to in. at	\$
Red'g } Coupl'gs	to in. at	\$
Inc'g }		\$
Union	in. at	\$
Meter	in. at	\$
Compound Joints		\$
Maintenance Foreman		\$
Hrs. Water Maint. Man-1	at	\$
Hrs. Water Maint. Man-2	at	\$
Hrs. Garage Foreman	at	\$
Hrs. Labor	at	\$
Hrs. Compressor	at	\$
Trucking		\$
Pav't Patch		\$
		\$
		\$
EAST FIELD

56  
Ave. No. 1690

Name of Owner

Labor and Mat'l. Report MARCH 26 1982

PRESS BOX

125' 3" 141'

13' 10" SIGN POST  
Curb Box SIGN POST  
7' 8"

12" Main

Elev. of Main at tap

Gate at

Gate at

2" LINE 8' 10" LONG  
Curb Box

## LABOR AND MATERIALS

Copper	} Connection	_____	\$ _____	
Lead				
Curb	} Cock Valve T. S. & V.	_____ in.	\$ _____	
Service box		} Short 3½ x 4½ Long 4½ x 5½ Buff or Rdway	_____	\$ _____
Old returned				
Ft. _____ in.	} Copper G. I. C. I.		Pipe at _____	\$ _____
Nipples _____ in.		at _____	\$ _____	
Bushings _____ to _____ in.		at _____	\$ _____	
Red'g } Inc'g }	} Coupl'gs	_____ to _____ in.	\$ _____	
Union _____ in.		at _____	\$ _____	
Meter _____ in.	at _____	\$ _____		
Lead Joints	at _____	\$ _____		
Compound Joints	at _____	\$ _____		
Maintenance Foreman	_____	\$ _____		
Hrs. Water Maint. Man—1	at _____	\$ _____		
Hrs. Water Maint. Man—2	at _____	\$ _____		
Hrs. Garage Foreman	at _____	\$ _____		
Hrs. Labor—	at _____	\$ _____		
Hrs. Compressor	at _____	\$ _____		
Compensation Ins. at \$ _____	per C _____	\$ _____		
Trucking	_____	\$ _____		
Pav't Patch	_____	\$ _____		
_____		\$ _____		
_____		\$ _____		
O'head _____		\$ _____		
		\$ _____		

EAST FIELD


TAP FOR  
EAST FIELD,  
CONCESSION-stand

St.  
Pl.  
Ave. No. \_\_\_\_\_

Name of Owner \_\_\_\_\_

### Labor and Mat'l. Report

19

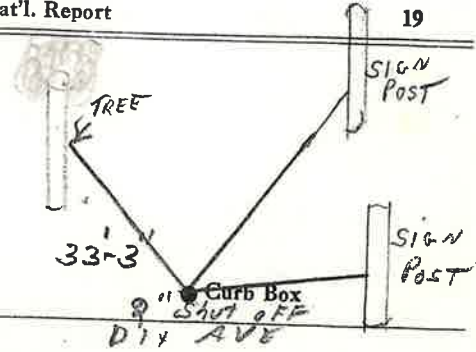

Main


Elev. of  
Main at tap \_\_\_\_\_

Gate at ●

● Gate at

● Curb Box

3-26-82  
measurements

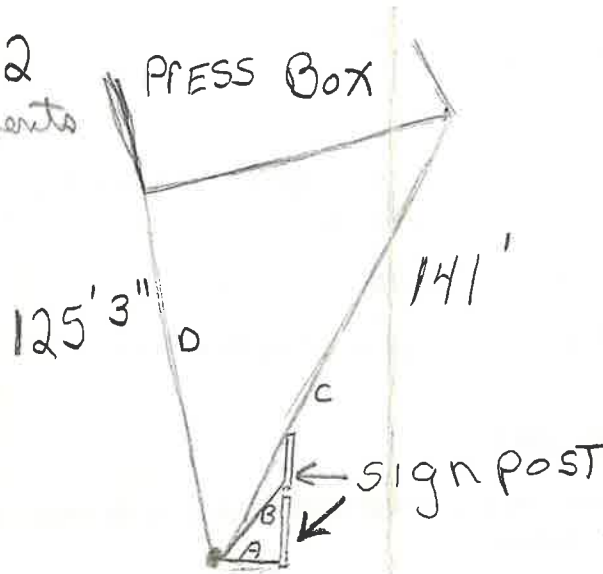

EAST Field TAP  
2" line 8 to 10' long

- A 7' 8"
- B 13' 10"
- C 141'
- D 125' 3"