


LABOR AND MATERIALS

1	Copper Lead	Connection	2"	\$
1	Curb	Cock Valve T.S. & V.	2 in.	\$
1	Service box Old returned Small	Short 3 1/2 x 4 1/2 Long 4 1/2 x 5 1/2 Buff or Rdway		\$
40 Ft.	2 in.	Copper G.I. C.I.	Pipe at	\$
	Nipples	in. at		\$
	Bushings	to in. at		\$
	Red'g Inc'g	Coupl'gs. to in. at		\$
	Union	in. at		\$
	Meter	in. at		\$
	Lead Joints	at		\$
1	Compound Joints	at		\$
	Maintenance Foreman			\$
	Hrs. Water Maint. Man	1 at		\$
	Hrs. Water Maint. Man	2 at		\$
	Hrs. Garage Foreman	at		\$
	Hrs. Labor	at		\$
	Hrs. Compressor	at		\$
	Compensation Ins.	at \$ per C		\$
	Trucking			\$
	Pav't Patch			\$
	Tap by Miller-Lareau			\$
	Co. 12-3-57			\$
	O'head			\$

DIX

Dix St. 208-
Pl. 214
Ave. No. 214

Name of Owner
Glentel Realty Co.
(Garage)
Labor and Mat'l. Report Dec. 3 1957

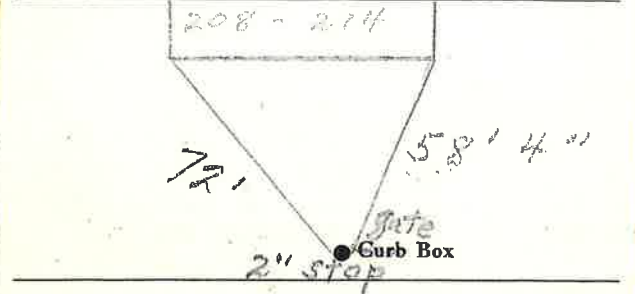

6" Main Elev. of Main at tap 5'-6"
Gate at • Gate at •

• Curb Box
Tel. Co. Garage