


LABOR AND MATERIALS

3 4	Copper } Connection _____ \$
Lead	Cock Valve } _____ in. \$
Curb	T. S. & V. } _____ in. \$
Service box	{ Short 3 1/2 x 4 1/2 } { Long 4 1/2 x 5 1/2 } { Buff or Rdway }
Old returned	
Ft. _____ in.	{ Copper } { G. I. } { C. I. }
Nipples _____ in.	at _____ \$
Bushings _____ to _____ in.	at _____ \$
Red'g } Inc'g }	Coupl'gs _____ to _____ in. at _____ \$
Union _____ in.	at _____ \$
Meter _____ in.	at _____ \$
Lead Joints	at _____ \$
Compound Joints	at _____ \$
Maintenance Foreman	_____ \$
Hrs. Water Maint. Man—1	at _____ \$
Hrs. Water Maint. Man—2	at _____ \$
Hrs. Garage Foreman	at _____ \$
Hrs. Labor—	at _____ \$
Hrs. Compressor at	_____ \$
Compensation Ins. at \$ _____	per C _____ \$
Trucking	_____ \$
Pav't Patch	_____ \$
_____	_____ \$
_____	_____ \$
O'head	_____ \$
_____	_____ \$

Dix ave.
 New York Telephone Ave. No. _____
 St. Pl. Ave. No. _____

Name of Owner _____

Labor and Mat'l. Report _____ 1980

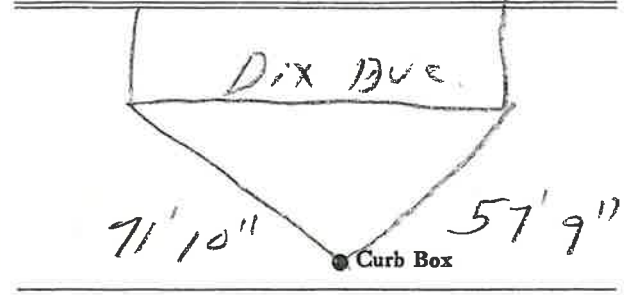

6 Main Elev. of Main at tap 5

Gate at • Gate at •

• Curb Box