

LABOR AND MATERIALS

Copper	} Connection		\$	
Lead				
Curb	} Cock			
		} Valve	in.	\$
			T. S. & V.	
1 Service box	} Short 3 1/2 x 4 1/2			
Old returned		} Long 4 1/2 x 5 1/2		
			Buff or Rdway	\$
? Ft.	} Copper			
in.		} G. I.	Pipe at	\$
			C. I.	
Nipples	in. at		\$	
Bushings	to in. at		\$	
Red'g	} Coupl'gs			
Inc'g		to in. at	\$	
Union	in. at		\$	
Meter	in. at		\$	
Lead Joints	at		\$	
Compound Joints	at		\$	
Maintenance Foreman			\$	
Hrs. Water Maint. Man—1	at		\$	
Hrs. Water Maint. Man—2	at		\$	
Hrs. Garage Foreman	at		\$	
Hrs. Labor—	at		\$	
Hrs. Compressor	at		\$	
Compensation Ins. at \$	per C		\$	
Trucking			\$	
Pav't Patch			\$	
			\$	
			\$	
O'head			\$	
			\$	

Lower
Dix

-St.
-Pl. 218
Ave. No.


Name of Owner

Ricciardelli

Measured in

Labor and Mat'l. Report

Oct 22 19 57

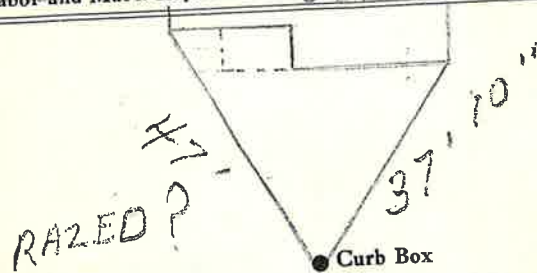

RAZED?

● Curb Box

Main Elev. of Main at tap

Gate at ● Gate at

● Curb Box