


LABOR AND MATERIALS

1	main Copper Lead	Connection	1 1/4" x 3/4" Elbow	\$	
1	Curb	Cook Valve T. S. & V.	3/4" in. Oriseal.	\$	
1	Service box Old returned	Short 3 1/2 x 4 1/2 Long 4 1/2 x 5 1/2 Buff or Rdway		\$	
7	Ft. 3/4 in.	Copper G. I. C. I.	Pipe at	\$	
1	Nipples	1 1/4 in. at	1 1/4" Galv.	\$	
	Bushings	to in. at		\$	
2	Red'g Inc'g	Male Adapters, Coupl'gs	to in. at	\$	
	Union	in. at	Cap to iron	\$	
	Meter	in. at		\$	
1	Lead Joints at	1 1/4" Dresser repair		\$	
	Compound Joints at	sleeve		\$	
24	Maintenance Foreman	4.50		\$	4.59
4	Hrs. Water Maint. Man-1	at 1.50		\$	
4	Hrs. Water Maint. Man-2	at .75		\$	
6	Hrs. Garage Foreman	at		\$	
	Hrs. Labor	at 10.90		\$	
3	Hrs. Compressor at	14.50		\$	
	Compensation Ins. at \$	per C		\$	
	Trucking			\$	
	Pav't Patch			\$	
	O'head			\$	

Dix  
-St. Pl. Ave. No. 225

Name of Owner  
Barker & Henry  
Labor and Mat'l. Report June 26 1970.

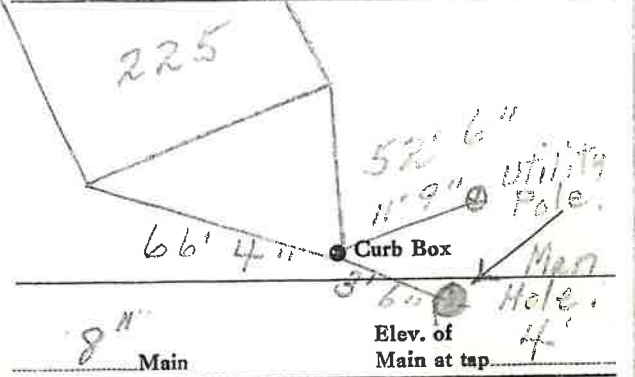

Gate at ● Gate at

● Curb Box