

LABOR AND MATERIALS

1	Copper Lead	Connection	1"	\$	_____
1	Curb	Cock Valve T.S. & V.	1" in.	\$	_____
1	Service box Old returned	Short 3 1/2 x 4 1/2 Long 4 1/2 x 5 1/2 Buff or Rdway		\$	_____
4'6"	4'6" Ft.	Copper G.I. G.I.	1 in. Pipe at	\$	_____
	Nipples	in.	at	\$	_____
	Bushings	to	in. at	\$	_____
	Red'g Inc'g	Coupl'gs	to in. at	\$	_____
	Union	in.	at	\$	_____
	Meter	in.	at	\$	_____
	Lead Joints at			\$	_____
	Compound Joints at			\$	_____
	Maintenance Foreman			\$	_____
	Hrs. Water Maint. Man-1	at		\$	_____
	Hrs. Water Maint. Man-2	at		\$	_____
	Hrs. Garage Foreman	at		\$	_____
	Hrs. Labor	at		\$	_____
	Hrs. Compressor at			\$	_____
	Compensation Ins. at \$	per C		\$	_____
	Trucking			\$	_____
	Pav't Patch			\$	_____
	O'head			\$	_____

SHUT OFF FOR
 8" MAIN INSTALLED - LATE '70'S
 Lower Dix St. Ext.
 Ave. No.

Name of Owner


1 1/4" Line

Labor and Mat'l. Report

19

N.Y. Power Pole #381
 N.Y. Telephone pole #41

Last Hydt. on
 on
 Dix Ave.
 #363

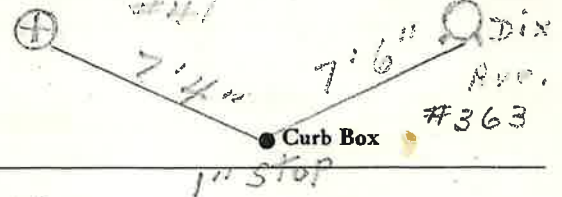

1 1/4" Main

Elev. of Main at tap 5'

Gate at • Gate at

• Curb Box
 N. ↑ This Tap on 6" Lateral to Hydt. on South side of gate