

LABOR AND MATERIALS


1	Copper Lead	Connection	3/4		\$ 2.80
1	Curb	Clock Valve	3/4	in.	\$ 3.60
1	Service box	Old returned	Short 3" X 4 1/2" Long 4" X 5 1/2" Buff or Rdway		\$ 5.80
27 Ft.	3/4 in.	Copper Galv. Iron Cast Iron	Pipe	25	\$ 9.45
	Nipples				\$
	Bushings				\$
	Red'g Inc'g	Couplings			\$
	Union				\$
	Meter				\$
	Lead Joints at				\$
	Compound Joints at				\$
	Hrs. Foreman at				\$
	Hrs. Chauffeur at				\$
	Hrs. Tapper at	91			\$ 2.73
	Hrs. Labor at	80			\$ 4.00
	Hrs. Labor at				\$
	Hrs. Compressor at				\$
	Compensation Ins.				\$
	Trucking				\$ 1.15
	Builders Use of Water				\$
	<i>Tap by Mignin</i>				
					\$
					\$
					\$
					\$
					\$ 19.53

154-47

Douglas Ave. No. 20
Name of Owner

Sherlock

Labor and Mat'l. Report Nov 27 19 47

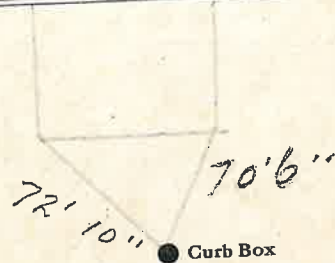

12 Main Elev. of Main at tap 5-
Gate at Gate at

Curb Box