


LABOR AND MATERIALS

Copper	}	Connection		\$		
Lead						
Curb	}	Cock	} in.	\$		
		Valve				
		T. S. & V.				
Service box	}	Short 3½ x 4½	} _____	\$		
		Old returned Long 4½ x 5½				
Ft.	}	3/4 in.	} Pipe at	\$		
						Copper
						G.I. G.I.
Nipples		in. at		\$		
Bushings		to in. at		\$		
Red'g	}	Coupl'gs	to in. at	\$		
						Inc'g
Union		in. at		\$		
Meter		in. at		\$		
				\$		
Compound Joints		at		\$		
Maintenance Foreman				\$		
Hrs. Water Maint. Man-1		at		\$		
Hrs. Water Maint. Man-2		at		\$		
Hrs. Garage Foreman		at		\$		
Hrs. Labor		at		\$		
Hrs. Compressor		at		\$		
				\$		
Trucking				\$		
Pav't Patch				\$		
				\$		
				\$		
~~St.~~
~~Pl.~~
 Ave. No. 21

Name of Owner _____

Labor and Mat'l. Report 19 93

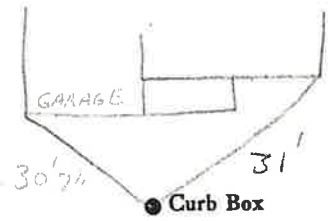

Main Elev. of Main at tap _____

Gate at ● ● Gate at

● Curb Box

Labor and Materials


.....	Copper } Connection.....	$\frac{3}{4}$	\$ 2.60
.....	Curb } Cock } Valve } V..... in.	$\frac{3}{4}$	\$ 2.27
.....	Service Box } Standard 4x4 1/2 Old retained } Long 4 1/2 x 5 1/2 } Diff. or Redway }		\$ 1.59
10.....	Ft. $\frac{3}{4}$ in. } Copper } Galv. Iron Pipe at.....		\$ 1.80
.....	Nipples..... in. at.....		\$
.....	Bushings..... to..... in. at.....		\$
.....	Red'g } Couplings..... to..... in. at.....		\$
.....	Inc'g }		\$
.....	Union..... in. at.....		\$
.....	Meter..... in. at.....		\$
.....	Lbs. Br. Stone at.....		\$
.....	Lbs. Sand at.....		\$
.....	Bags Cement at.....		\$
.....	Paving Brick } Mack } Red } Asphalt } at.....		\$
.....	Lead Joints at.....		\$
.....	Leadite Joints at.....		\$
3.....	Hrs. Foreman at.....		\$ 1.88
6.....	Hrs. Common Labor at.....		\$ 2.70
.....	Hrs. Common Labor at.....		\$
.....	Hrs. Mason at.....		\$
.....	Hrs. Mason's Helper at.....		\$
.....	Hrs. Compressor at.....		\$
.....	Compensation Ins.....		\$.14
.....	Trucking.....		\$ 1.00
.....	Builders' Use of Water Patch.....		\$ 1.00
	Total \$		13.98

31-217 21

Labor and Material Report

Oct. 15 1971

15 Douglas Ave.

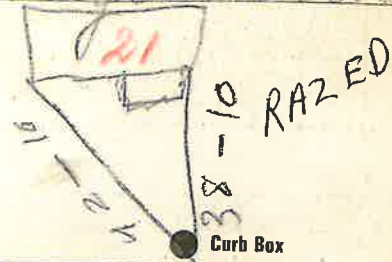

12" Main

Elev of Main at tap 41 1/2

Gate at ●

● Gate at

● Curb Box

New house

SHUT OFF AT CURB