


LABOR AND MATERIALS

1	Copper Lead	} Connection $\frac{3}{4}$			\$
1	Curb	} Cock Valve } $\frac{3}{4}$ in.			\$
		T. S. & V.			
1	Service box Old returned	} Short $3\frac{1}{2} \times 4\frac{1}{2}$ Long $4\frac{1}{2} \times 5\frac{1}{2}$			\$
9	Ft. $\frac{3}{4}$ in.	} Copper C.I.	} Pipe at		\$
	Nipples	in. at			\$
	Bushings	to in. at			\$
	Red'g Inc'g	} Coupl'gs	to in. at		\$
	Union	in. at			\$
	Meter	in. at			\$
					\$
	Compound Joints	at			\$
	Maintenance Foreman				\$
	Hrs. Water Maint. Man	—1 at			\$
	Hrs. Water Maint. Man	—2 at			\$
	Hrs. Garage Foreman	at			\$
	Hrs. Labor	at			\$
	Hrs. Compressor	at			\$
					\$
	Trucking				\$
	Pav't Patch				\$
					\$
					\$
					\$
					\$

DOUGLAS Ave. No. 27

Name of Owner _____

Labor and Mat'l. Report AUG. 25 1928

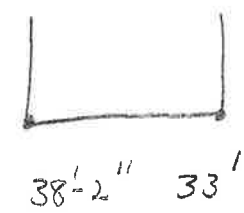

● Curb Box

12 Main Elev. of Main at tap 42'

Gate at ● Gate at ●

● Curb Box