

LABOR AND MATERIALS

1	Copper Lead	Connection	3/4"	\$	3.08
1	Curb	Cock Valve T.S. & V.	3/4 in.	\$	3.89
1	Service box	Short 3 1/2 x 4 1/2			
	Old returned	Long 4 1/2 x 5 1/2		\$	4.32
3	Ft. 3/4 in.	Copper G.I. C.I. Pipe at	45	\$	1.35
	Nipples	in. at		\$	
	Bushings	to in. at		\$	
	Red'g Inc'g	Coupl'gs. to in. at		\$	
	Union	in. at		\$	
	Meter	in. at		\$	
	Lead Joints	at		\$	
	Compound Joints	at		\$	
	Maintenance Foreman			\$	1.00
	Hrs. Water Maint. Man-1	at		\$	
✓	Hrs. Water Maint. Man-2	at 1.613		\$	3.23
	Hrs. Garage Foreman	at		\$	
✓	Hrs. Labor	at 130		\$	260
	Hrs. Compressor	at		\$	
	Compensation Ins. at \$	5.686 per C.		\$	1.33
	Trucking			\$	1.50
	Pav't Patch			\$	9.00
	Tap by Gifford			\$	
				\$	
	O'head			\$	
				\$	29.80

Douglas


St. Ave. No. 9

Name of Owner

James Hamell

Labor and Mat'l. Report

JUNE 20 1956

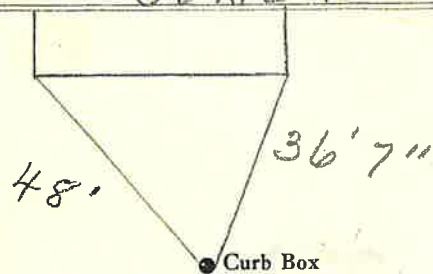

12" Main

Elev. of Main at tap 4 1/2'

Gate at •

• Gate at

• Curb Box