


LABOR AND MATERIALS

1	Copper	Connection	3/4"	\$
1	Curb	Cock Valve T.S. & V.	3/4" in.	\$
1	Service Box	Shown 3/4" x 1/2"		\$
1	Old returned	Long 4 1/2 x 5 1/2"		\$
28	28 Ft.	3/4" in.	Copper Galv. Iron Cast Iron	Pipe at \$
	Nipples	in. at		\$
	Bushings	to in. at		\$
	Red'g Inc'g	Couplings to in. at		\$
	Union	in. at		\$
	Meter	in. at		\$
	Lead Joints	at		\$
	Leadite Joints	at		\$
	Hrs. Foreman	at		\$
	Hrs. Chauffeur	at		\$
	Hrs. Tapper	at		\$
	Hrs. Labor	at		\$
	Hrs. Labor	at		\$
	Hrs. Compressor	at		\$
	Compensation Ins.			\$
	Trucking			\$
	Builders Use of Water			\$
				\$
				\$
				\$
				\$

St. **16**
 Pt. **10**
 Ave. No. **10**
 Name of Owner Douglas

Labor and Mat'l. Report AUG. 17 1999

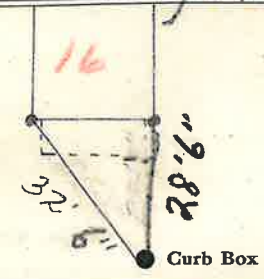

12" Main Elev. of Main at tap **3 1/2'**
 Gate at ● Gate at ●

● Curb Box

TAP MADE BY LAREAU
 NOV 17-1969