


LABOR AND MATERIALS

Copper } Connection		\$	
Lead } Connection		\$	
Curb	Cock Valve } T. S. & V. } in.	\$	
			\$
			\$
Service box	Short 3 1/2 x 4 1/2 } Long 4 1/2 x 5 1/2 }		
Old returned		\$	
Ft. 3/4 in.	Copper } G.I. } G.I. }	Pipe at	\$
Nipples	in. at	\$	
Bushings	to in. at	\$	
Red'g } Inc'g }	Coupl'gs	to in. at	\$
Union	in. at	\$	
Meter	in. at	\$	
		\$	
Compound Joints	at	\$	
Maintenance Foreman		\$	
Hrs. Water Maint. Man-1	at	\$	
Hrs. Water Maint. Man-2	at	\$	
Hrs. Garage Foreman	at	\$	
Hrs. Labor	at	\$	
Hrs. Compressor	at	\$	
		\$	
Trucking		\$	
Pav't Patch		\$	
		\$	
		\$	
St. Douglas
Pl. 17
Ave. No. 17

Name of Owner Stanley Juckitt

Labor and Mat'l. Report 19 88

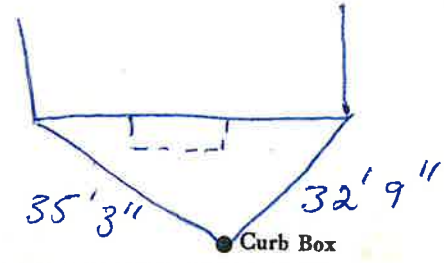

Main Elev. of Main at tap

Gate at • Gate at •

• Curb Box