

LABOR AND MATERIALS

Copper	} Connection	_____	\$ _____	
Lead				
Curb	} Cock	} _____ in.	\$ _____	
				} Valve
1 Service box	} Short 3½ x 4½	} _____	\$ _____	
Old returned				} Long 4½ x 5½
Ft. _____ in.	} Copper	} Pipe at _____	\$ _____	
				} G. I.
Nipples	_____ in. at _____	\$ _____		
Bushings	_____ to _____ in. at _____	\$ _____		
Red'g	} Coupl'gs. _____ to _____ in. at _____	\$ _____		
Inc'g				
Union	_____ in. at _____	\$ _____		
Meter	_____ in. at _____	\$ _____		
Lead Joints	at _____	\$ _____		
Compound Joints	at _____	\$ _____		
Maintenance Foreman	_____	\$ _____		
Hrs. Water Maint. Man—1	at _____	\$ _____		
Hrs. Water Maint. Man—2	at _____	\$ _____		
Hrs. Garage Foreman	_____ at _____	\$ _____		
Hrs. Labor—	_____ at _____	\$ _____		
Hrs. Compressor	at _____	\$ _____		
Compensation Ins. at \$ _____	per C _____	\$ _____		
Trucking	_____	\$ _____		
Pav't Patch	_____	\$ _____		
	_____	\$ _____		
	_____	\$ _____		
O'head	_____	\$ _____		
	_____	\$ _____		


Measured 10-8-65

GARAGE

St. _____
Pl. _____
Ave. No. 1

Name of Owner _____
Was. _____
F. F. Floyd Fort.

Labor and Mat'l. Report _____
OCT 19 19 37

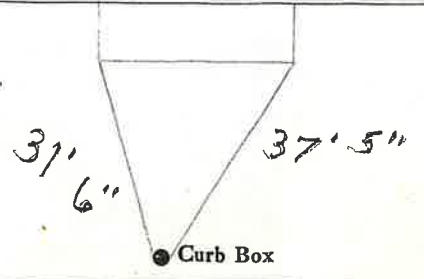

4" Main _____ Elev. of Main at tap 52'

Gate at • _____ • Gate at _____

Note: • Curb Box
See # 7 Taylor St.