


LABOR AND MATERIALS

Copper	} Connection	_____	\$ _____	
Lead				
Curb	} Cock	_____ in.	\$ _____	
				} Valve
1 Service box	} Short 3½ x 4½	_____	\$ _____	
Old returned				} Long 4½ x 5½
				} Buff or Rdway
Ft. _____ in.	} Copper	Pipe at _____	\$ _____	
				} G. I.
				} C. I.
Nipples _____ in.	at _____	\$ _____		
Bushings _____ to _____ in.	at _____	\$ _____		
Red'g } Inc'g }	} Coupl'gs _____ to _____ in.	at _____	\$ _____	
Union _____ in.				at _____
Meter _____ in.	at _____	\$ _____		
Lead Joints at _____		\$ _____		
Compound Joints at _____		\$ _____		
Maintenance Foreman _____		\$ _____		
Hrs. Water Maint. Man—1 at _____		\$ _____		
Hrs. Water Maint. Man—2 at _____		\$ _____		
Hrs. Garage Foreman _____ at _____		\$ _____		
Hrs. Labor— _____ at _____		\$ _____		
Hrs. Compressor at _____		\$ _____		
Compensation Ins. at \$ _____ per C.		\$ _____		
Trucking _____		\$ _____		
Pav't Patch _____		\$ _____		
_____		\$ _____		
_____		\$ _____		
_____		\$ _____		
O'head _____		\$ _____		
_____		\$ _____		

Dudley St. Pl. Ave. No. 10

Name of Owner Bemis
 Measured in Labor and Mat'l. Report Nov. 13 1961

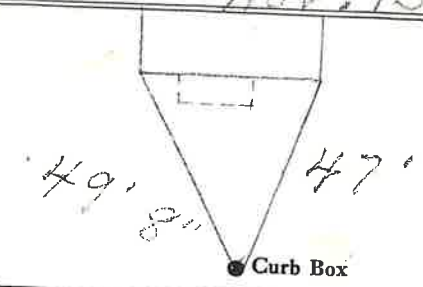

Main Elev. of Main at tap
 Gate at • Gate at •
 • Curb Box