

# LABOR AND MATERIALS


_____	Copper } Connection _____	\$ _____
_____	Lead } _____	\$ _____
_____	Curb } Cock	_____ in. _____
	} Valve	
	} T.S. & V. }	\$ _____
_____	Service box { Short 3-1/2 x 4-1/2	\$ _____
_____	Old returned { Long 4-1/2 x 5-1/2	\$ _____
<u>23</u>	Ft. _____ in. { Copper	Pipe at _____ \$ _____
_____	Nipples _____ in. at _____	\$ _____
_____	Bushings _____ to _____ in. at _____	\$ _____
_____	Red'g _____	\$ _____
_____	Inc'g _____	\$ _____
_____	Union _____ in. at _____	\$ _____
_____	Meter _____ in. at _____	\$ _____
_____	_____	\$ _____
_____	Compound Joints at _____	\$ _____
_____	Maintenance Foreman _____	\$ _____
_____	Hrs. Water Maint. Man - 1 at _____	\$ _____
_____	Hrs. Water Maint. Man - 2 at _____	\$ _____
_____	Hrs. Garage Foreman _____ at _____	\$ _____
_____	Hrs. Labor _____ at _____	\$ _____
_____	Hrs. Compressor at _____	\$ _____
_____	_____	\$ _____
_____	Trucking _____	\$ _____
_____	Pav't Patch _____	\$ _____
_____	_____	\$ _____
_____	_____	\$ _____
EDGEWATER

Pl. No. 15

Name of Owner \_\_\_\_\_

Labor and Mat'l. Report 1990

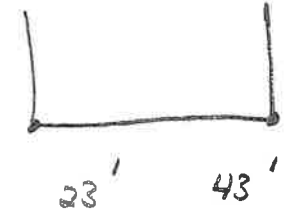

● Curb Box

\_\_\_\_\_ Main

Elev. of Main at tap \_\_\_\_\_

Gate at ●

● Gate at

● Curb Box