


LABOR AND MATERIALS

1	Copper Lead	} Connection	3/4"	}	\$
1	Curb				
1	Service box Old returned	} Short 3 1/2 x 4 1/2 Buff or Redway	}	\$	
6	Ft. 3/4 in.				} Copper C.I. C.I.
	Nipples	in. at	\$		
	Bushings	to	in. at	\$	
	Red'g Inc'g	} Coupl'gs	to	in. at	\$
	Union				
	Meter	in. at	\$		
	Lead Joints	at	\$		
	Compound Joints	at	\$		
	Maintenance Foreman		\$		
	Hrs. Water Maint. Man-1	at	\$		
	Hrs. Water Maint. Man-2	at	\$		
	Hrs. Garage Foreman	at	\$		
	Hrs. Labor	at	\$		
	Hrs. Compressor	at	\$		
	Compensation Ins. at \$	per C	\$		
	Trucking		\$		
	Pav't Patch		\$		
	TAP MADE BY PECK				\$
	O'head	8-31-1972		\$	

Edison Rd. St Pt. Ave. No. 3

Name of Owner
Charles Apleyard

Labor and Mat'l. Report AUG 31 1972

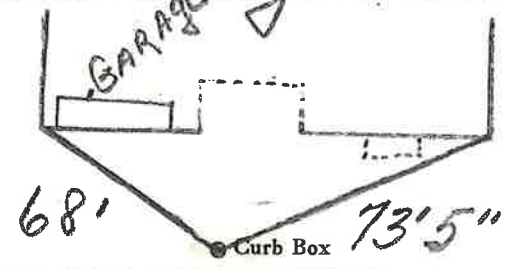

6" Main Elev. of Main at tap 4 1/2"

Gate at • • Gate at
6' to main

• Curb Box